



MUNICIPAL SERVICES DEPARTMENT
ENGINEERING DIVISION
156 S. BROADWAY, SUITE 150
TURLOCK, CA 95380

PHONE: (209) 668-5520
FAX: (209) 668-5563
TDD: (800) 735-2929
engineering@turlock.ca.us

Date: 11/13/25

City Project No.: 25-051

Addendum No.: 1

Plan holders:

Item No. 1 - Replace the “Bidder’s Form” with the attached “Bidder’s Form (Addendum No. 1)”. Contractor shall submit bids using the “Bidder’s Form (Addendum No. 1)”.

The City has received several requests for information and has provided clarification below.

- 1. Question:** Item 17 and 18 are allowances and I cannot find the allowance amounts in the bid documents? The description says they are included on the bid form; however, they are not on the written one in the specifications. Can you please advise?

Answer: See Bidder’s Form (Addendum No. 1) for updates.

- 2. Question: Will the City be conducting the CCTV operations?**

Answer: Yes.

- 3. Question: Could you please clarify whether contractors will be permitted to use open-cut techniques for the installation of sewer laterals, given the nature of the work?**

Answer: Yes. Contractors will be permitted to use open-cut methods for the installation of sewer laterals. Please refer to revised Sections 10.12 and 10.13 included in Addendum No. 1 for specific requirements. The City’s primary concern is avoiding disturbance to the recently replaced curb and gutter, and all open-cut activities shall be planned and executed to prevent impacts to these improvements.

- 4. Question: Will contractors be mandated to engage a certified arborist for tree trimming activities?**

Answer: No.

- 5. Question: Could you please provide the anticipated date for the Notice to Proceed?**

Answer: Provided the Agreement is executed in a timely manner, the City anticipates awarding the bid on December 9th and issuing the Notice to Proceed on December 22nd.

Revisions to Plans and Specifications

The following additions, deletions or modifications shall become part of the Contract Documents:

Strikethrough text (~~text~~) indicates deletions.

Bold Italicized text (**text**) indicates additions.

Project Plans:

Item No. 2 – Sheets 3, 4 and 5

Remove and replace Sheets 3, 4 and 5 with the attached sheets.

Project Specifications:

Item No. 3 – Section 10.12 is amended to read as follows:

10.12 SANITARY SEWER SERVICE LATERAL (SDR-26) WITH CLEAN OUT:

Contractor shall replace sanitary sewer service laterals ~~using a trenchless installation method~~ in accordance with the City of Turlock Standard Specifications and Drawings, the Project Plans, and these Special Provisions. Pipe material shall be PVC SDR-26.

~~The trenchless method shall be performed in a manner that minimizes disturbance to existing pavement, landscaping, and other surface improvements. Prior to installation, the Contractor shall verify the horizontal and vertical alignment of the existing service connection and confirm the location of at the property line clean-out and new mainline connection. All disturbed areas, including paving, concrete, and landscaping, shall be restored to their original condition or better, at no additional cost to the City.~~ **Existing curb and gutter shall not be disturbed for this work. All other disturbed areas such as landscaping shall be restored to their original condition or better.**

Contractor shall pothole the locations of all sanitary sewer services to be replaced and confirm elevations will work to connect to **the new** sewer main. Provide pothole information to the City within five (5) working days prior to starting any excavation and notify the City of any conflicts. Contractor shall dig, lay, and backfill sanitary sewer pipe in accordance with City of Turlock Standard Specifications Section 14 (Errata 1), the Project Plans, and these Special Provisions.

PAYMENT

The contract price paid per each for Sanitary Sewer Service Lateral **with Clean Out (SDR-26)** shall include full compensation for furnishing all labor, materials, tools, equipment, and incidentals and for doing all the work involved in constructing the sanitary sewer pipe, complete in place, as shown on the Project Plans, and as required by law, as specified in the City of Turlock Standard Specifications and these Special Provisions, and as directed by the City Engineer. Specifically included in the price paid for each Sanitary Sewer Service Lateral is the cleanout assembly and all materials required to connect to existing sewer main **per City of Turlock Standard Specifications and Drawings.**

Item No. 4 - Section 10.13 is amended to read as follows:

10.13 SANITARY SEWER SERVICE LATERAL (C-900 DR-14) WITH CLEAN OUT:

Where sanitary sewer service laterals cross within 12-in of a water main, a minimum 20-ft section of the sanitary sewer service shall be PVC C900-07, Pressure Class 305, DR-14 centered on the water main. Contractor shall replace sanitary sewer service laterals ~~using a trenchless installation method~~ in accordance with the City of Turlock Standard Specifications and Drawings, the Project Plans, and these Special Provisions.

~~The trenchless method shall be performed in a manner that minimizes disturbance to existing pavement, landscaping, and other surface improvements.~~ Prior to installation, the Contractor shall verify the horizontal and vertical alignment of the existing service connection ~~and confirm the location of~~ **at** the property line cleanout and mainline connection. All disturbed areas, including paving, concrete, and landscaping, shall be restored to their original condition or better, at no additional cost to the City.

Contractor shall pothole the locations of all sanitary sewer services to be replaced and confirm elevations will work to connect to **the new** sewer main. Provide pothole information to the City within five (5) working days prior to starting any excavation and notify the City of any conflicts. Contractor shall dig, lay, and backfill sanitary sewer pipe in accordance with City of Turlock Standard Specifications Section 14 (Errata 1), the Project Plans, and these Special Provisions.

PAYMENT

The contract price paid per each for Sanitary Sewer Service Lateral (C-900 DR-14) **with clean-out** shall include full compensation for furnishing all labor, materials, tools, equipment, and incidentals and for doing all the work involved in constructing the sanitary sewer pipe, complete in place, as shown on the Project Plans, and as required by law, as specified in the City of Turlock Standard Specifications and these Special Provisions, and as directed by the City Engineer. Specifically included in the price paid for each Sanitary Sewer Service Lateral (C-900 DR-14) is the cleanout assembly and all materials required to connect to existing sewer main **per City of Turlock Standard Specifications and Drawings.**

Item No. 5 - Section 10.18 is amended to read as follows:

10.18 HOT MIX ASPHALT:

Hot Mix Asphalt (HMA) shall conform to the provisions in Section 39, "Hot Mix Asphalt," of the Caltrans Standard Specifications.

The HMA construction process shall be standard. The aggregate gradation of the top lift shall be ½" and the HMA type shall be type A. The binder shall be PG ~~70-10~~ **64-10**.

Contractor shall submit a quality control plan with the JMF. The JMF will not be accepted until the quality control plan is submitted.

Contractor shall tack coat all surfaces to receive HMA and shall conform to the Caltrans Standard Specifications Section 39, "Hot Mix Asphalt."

PAYMENT

Full compensation for furnishing all labor, materials, tools, equipment, and incidentals, and for doing all of the work involved with installing **hot mix asphalt** ~~on an aggregate base~~ as specified above per Step T-2, shall

be considered as included in the price paid for installing the sanitary sewer pipe and no additional compensation will be allowed therefor.

Item No. 6 – Remove Section 10.15 in its entirety.

Item No. 7 - Section 10.24 is amended to read as follows:

10.24 BID ALTERNATE A2 - TEMPORARY HANDLING OF WASTEWATER FLOWS:

The Contractor shall implement a Sewer Bypass Plan if needed. Temporary handling of wastewater flows shall consist of providing temporary wastewater bypass pumping systems, wastewater flow diversions as may be approved by the Engineer, and restoring wastewater flows to normal service conditions, as shown on the Plans, in conformance with the provisions in the Specifications, and as directed by the Engineer.

The approved Sewer Bypass Plan shall remain on-site during all portions of the work. Specific notification requirements and procedures shall be confirmed the project pre-construction meeting.

The Contractor is solely responsible for any releases of raw sewage due to failure of any component of the bypass pumping system, including backup containment measures. The Contractor shall reimburse the City for any and all costs such as assistance in cleanup and traffic control in case of sewer spill in conjunction with this work, fines by other government agencies and water quality testing costs.

Continuously operate and maintain failsafe temporary wastewater handling systems on a 24 hour per day basis, 7 days per week, including nights, weekends and holidays, whenever operations will otherwise result in the disruption of continuous wastewater conveyance. Provide continuous sanitary sewer service for all sewer mains and sewer services tributary to project sewers, and cooperate and coordinate temporary wastewater handling operations with the City of Turlock as directed by the Engineer.

PAYMENT

The contract lump sum price paid for Temporary Handling of Wastewater Flows shall include full compensation for furnishing all labor, materials, tools, equipment, and incidentals and for doing all the work involved in Temporary Handling of Wastewater Flows, complete in place, including setup, operation, maintenance and removal wastewater bypass pumping and diversion systems; permits; preparation of detailed temporary wastewater handling plans and calculations; preparation of an emergency spill response plan; sewer service interruptions and notifications thereof; and related facilities or improvements constructed at the Contractor's option; as shown on the Plans, in conformance with the provisions in the Standard Specifications, and as directed by the Engineer.

Sincerely,



Janine Lee
Project Manager

BIDDER'S FORM

PROJECT TITLE: El Paseo Sanitary Sewer Main Replacement

PROJECT NUMBER: 25-051

OPENING DATE: November 25, 2025

OPENING TIME: 10:00 AM

Item No.	Item Description	Unit of Measure	Estimated Quantity	Unit Price	Total
1	Mobilization & Demobilization	LS	1		
2	Construction Project Signs	EA	2		
3	Traffic Control System	LS	1		
4	Pothole Existing Utilities	LS	1		
5	Remove Existing Improvements	LS	1		
6	Tree Trimming	EA	2		
7	Earthwork	LS	1		
8	Shoring, Sheeting, and Bracing	LS	1		
9	Sanitary Sewer Manhole	EA	4		
10	8-in Sanitary Sewer Pipe (SDR-26)	LF	1,150		
11	4-in Sanitary Sewer Service Lateral (SDR-26) with Cleanout, Connect to New	EA	14		
12	4-in Sanitary Sewer Service Lateral (C-900 DR-14) with Cleanout, Connect to New	EA	7		
13	Abandon Existing Sewer Pipe with Grout	LF	1,150		
14	Adjust Frames and Covers to Grade	EA	4		
15	Allowance for Unknown Utilities	LS	1	\$5,000.00	
16	Allowance for Irrigation Repairs	LS	1	\$5,000.00	
17	Other Work Not Covered by Bid Items	LS	1		
Subtotal					

The basis of award shall be the lowest bid price on the base contract without consideration of the prices on the additive items

BID ALTERNATE "A"					
Item No.	Item Description	Unit of Measure	Estimated Quantity	Unit Price	Total
A1	Remove Existing Sanitary Sewer Line and Install New Sanitary Sewer Line in Place	LF	1,150		
A2	Temporary Handling of Wastewater Flows	LS	1		

Bidder has examined and carefully studied the Bidding documents and other related data identified in the Bidding Documents and the following Addenda, receipt of which is hereby acknowledged

ADDENDA

No. _____ Date _____ Signed _____

No. _____ Date _____ Signed _____

TOTAL BASE BID WRITTEN IN FIGURES: \$ __, __ __ __, __ __ __. __ __

TOTAL BASE BID WRITTEN IN WORDS: _____


CONTRACTOR SIGNATURE: _____

G:\25050 City of Turlock CP 25-051 EL Paseo & Arbor SS Replacement\ENGINEERING FILES AND DRAWINGS\DRAWINGS\2505005GN-CP 25-051.dwg PLOT Nov 12, 2025 AT 10:27AM



UNDERGROUND FACILITIES SHOWN WERE LOCATED BASED ON INFORMATION PROVIDED BY UTILITY COMPANIES AND BY MEASURING SURFACE FEATURES. NO ATTEMPT WAS MADE TO LOCATE OTHER UNDERGROUND FACILITIES THAT WERE NOT READILY APPARENT FROM A VISUAL INSPECTION OF SURFACE FEATURES.

CONTRACTOR SHALL VERIFY ACTUAL DEPTH AND LOCATION OF ALL EXISTING UTILITIES PRIOR TO CONSTRUCTION. CALL 811 TO CONTACT "UNDERGROUND SERVICE ALERT" (U.S.A.) PRIOR TO TRENCHING, GRADING, EXCAVATION, DRILLING, PIPE PUSHING, PLANTING TREES, DIGGING POST HOLES FOR FENCES, ETC. U.S.A. WILL SUPPLY INFORMATION OR LOCATE AND MARK ANY UNDERGROUND FACILITIES.

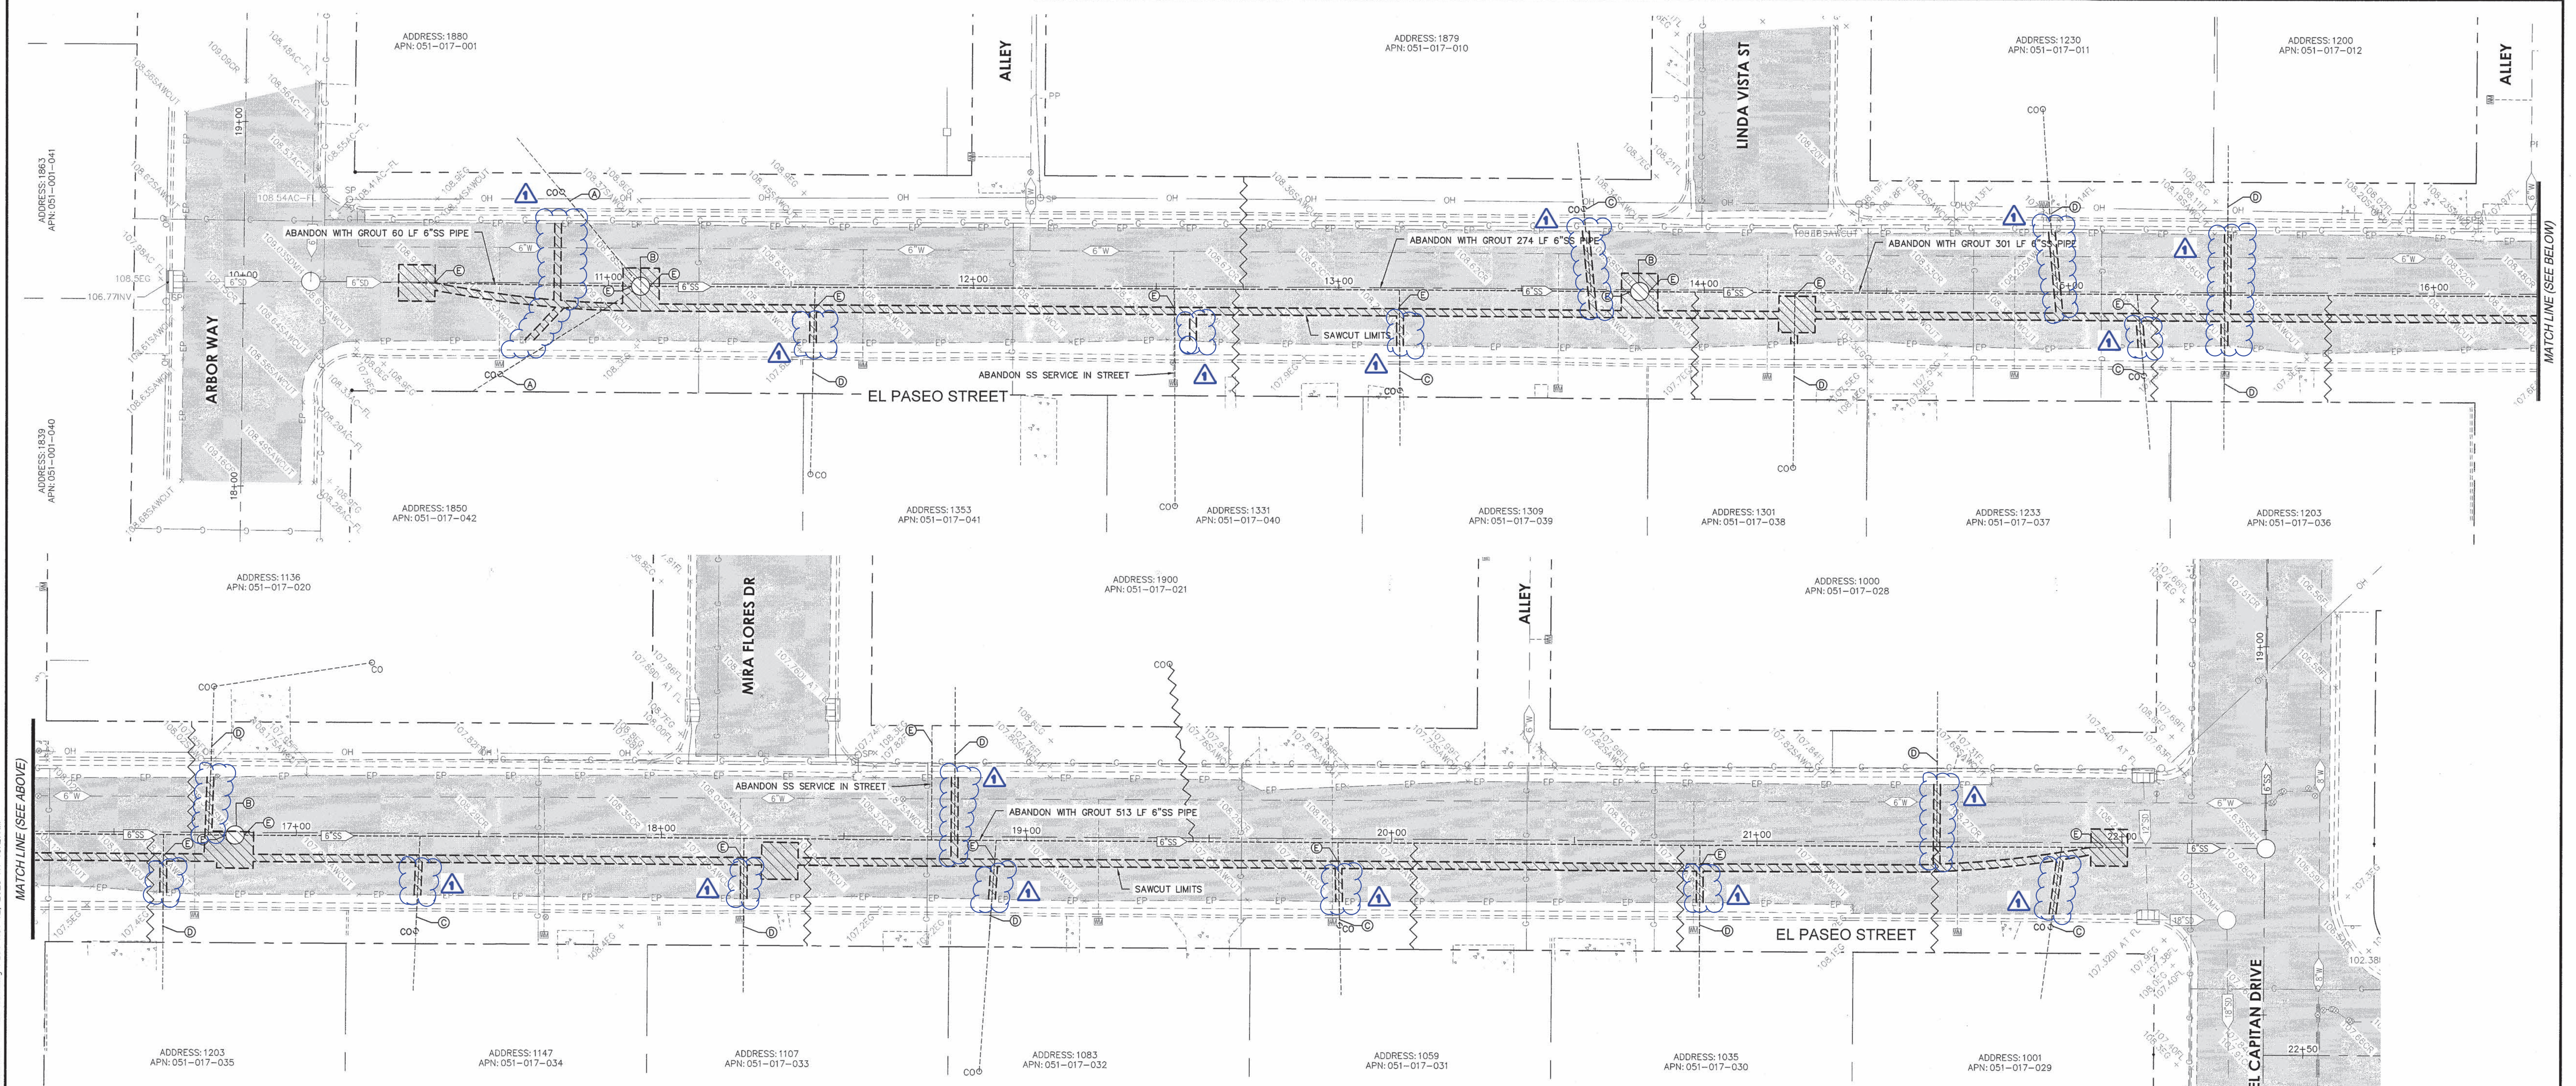

- DEMOLITION LEGEND:**
- (A) R & D CO, ABANDON SS SERVICE AND PLUG
 - (B) R & D MANHOLE
 - (C) R & D CO AND SS SERVICE WITHIN NEW SERVICE ALIGNMENT
 - (D) R & D SS SERVICE WITHIN NEW SERVICE ALIGNMENT
 - (E) PLUG PIPE END
 - (F) R & R STRIPING/PAVEMENT MARKINGS
- TRENCH PATCH WITHIN SAWCUT. SEE TRENCH PATCH DETAILS T-1 THRU T-2
- EXISTING ABANDONED SS SERVICE (PLUGGED)
- SAWCUT

- NOTE:**
- CONTRACTOR SHALL POTHOLE & VERIFY UTILITY POINTS OF CONNECTION PRIOR TO BEGINNING WORK.
 - PROTECT ALL TREES, POWER POLES, ELECTROUTERS, DRAIN INLETS, CATCH BASINS & UNDER GROUND UTILITIES IN-PLACE.
 - EXISTING SEWER MAIN TO REMAIN IN SERVICE UNTIL NEW MAIN AND LATERALS ARE INSTALLED, TESTED AND APPROVED.
 - BASE BID: ABANDON SEWER MAINS SIZE 6" AND GREATER BY FILLING WITH SAND CEMENT SLURRY. ADD ALTERNATE: EXISTING SEWER MAIN TO BE REMOVED AND NEW SEWER MAIN TO BE INSTALLED IN PLACE.
 - SERVICES THAT ARE HAVING PLUGS INSTALLED WILL BE ABANDONED IN-PLACE.
 - PROTECT CURB & GUTTER IN-PLACE.

CAUTION:
UNAUTHORIZED CHANGES AND USES

THE ENGINEER PREPARING THESE PLANS WILL NOT BE RESPONSIBLE FOR OR LIABLE FOR UNAUTHORIZED CHANGES TO OR USES OF THESE PLANS. ALL CHANGES TO THE PLANS MUST BE IN WRITING AND MUST BE APPROVED BY THE PREPARER OF THESE PLANS AND THE CITY ENGINEER.


DESCRIPTION	DATE	BY	CHECKED
ADDENDUM 1 - ADDED SS LATERAL TRENCH PATCH	11/13/25	JA	



GDR ENGINEERING, INC.
ENGINEERING/SURVEYING/PLANNING
3525 MITCHELL ROAD, SUITE G CERES, CA 95307
TELEPHONE: (209) 538-3360 FAX: (209) 538-7370
E-MAIL: GDRENGINEERING@GDRENG.COM

CITY OF TURLOCK - CP 25-051
EL PASEO SANITARY SEWER MAIN REPLACEMENT
EL PASEO TOPOGRAPHIC & DEMOLITION

SCALE: AS NOTED DATE: 11/12/2025
DWS NO. 2505005GN-CP 25-051.dwg LAYOUT: 3-TD
DRAWN: JA SHEET: 3 OF 6
FILE NO. 25050

DATE SIGNED: 11/12/2025

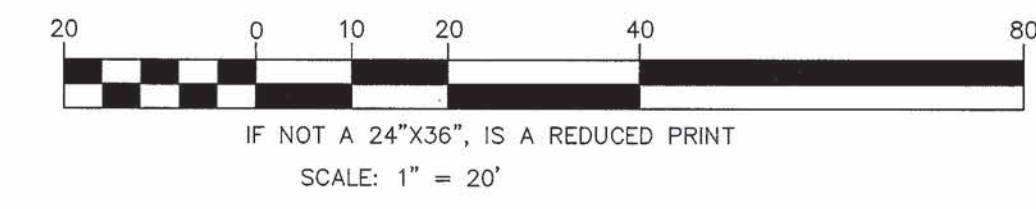

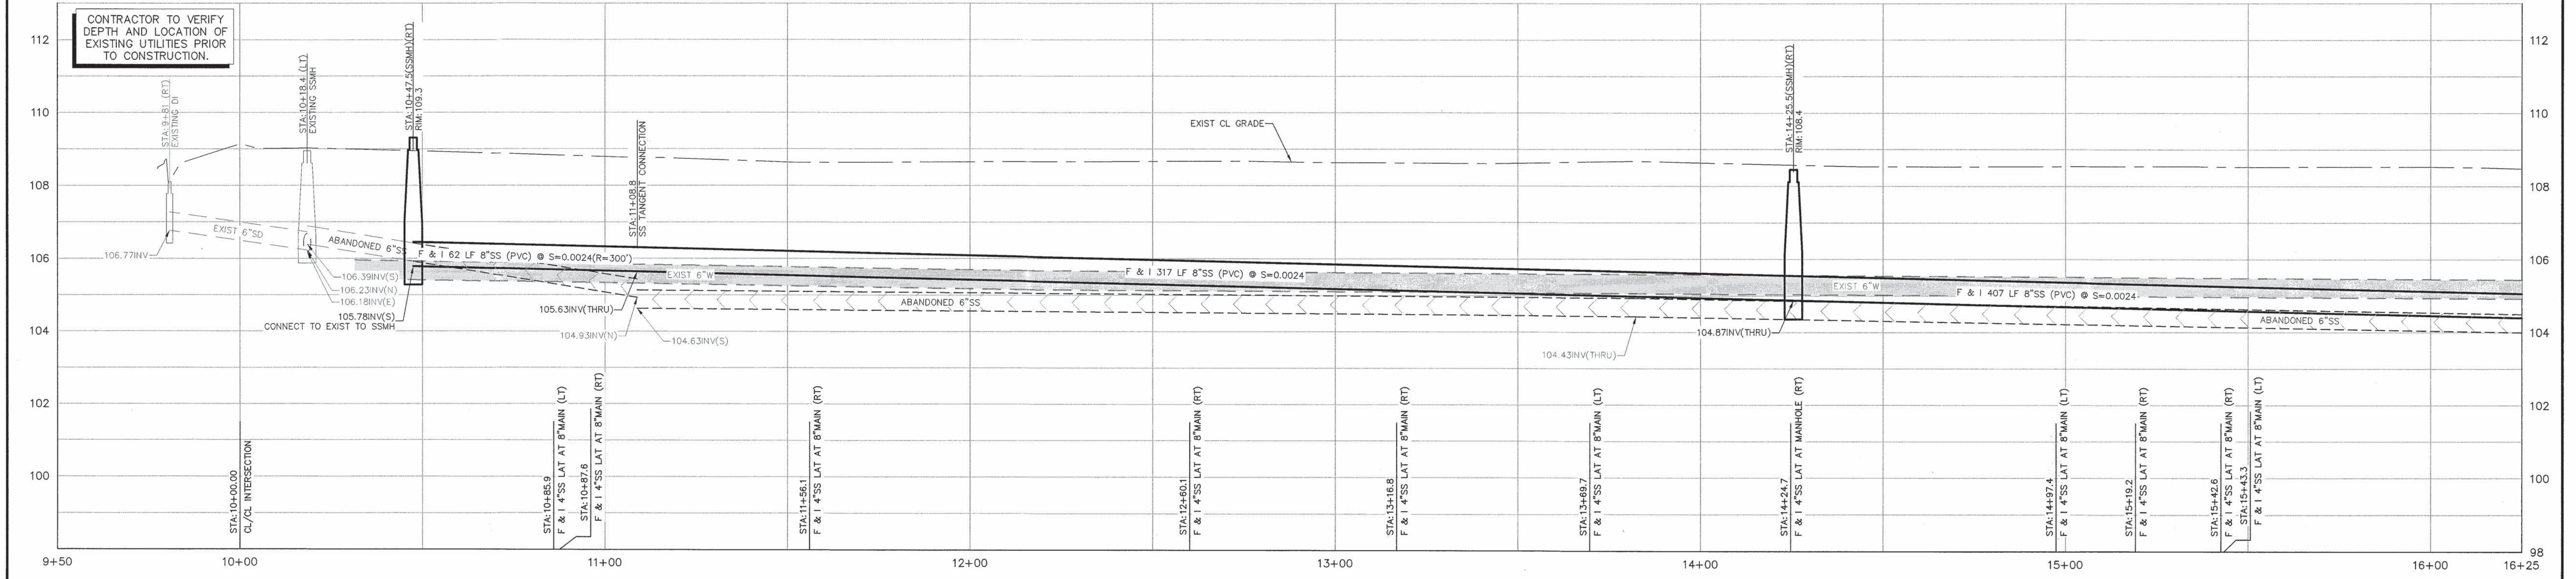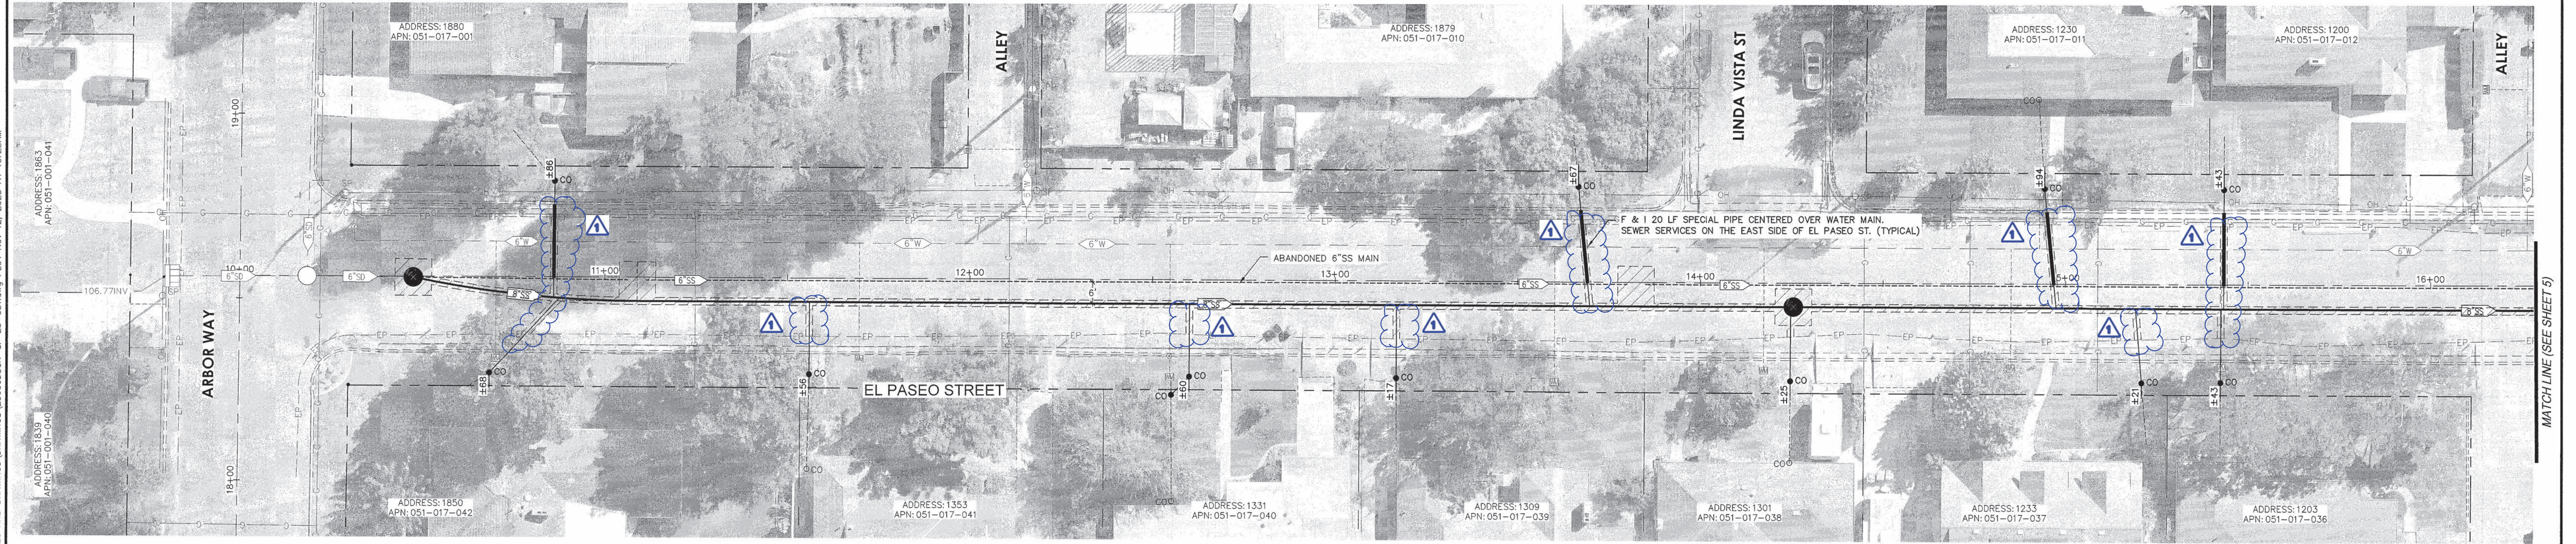


CALL BEFORE YOU DIG
811

UNDERGROUND FACILITIES SHOWN WERE LOCATED BASED ON INFORMATION PROVIDED BY UTILITY COMPANIES AND BY MEASURING SURFACE FEATURES. NO ATTEMPT WAS MADE TO LOCATE OTHER UNDERGROUND FACILITIES THAT WERE NOT READILY APPARENT FROM A VISUAL INSPECTION OF SURFACE FEATURES.

CONTRACTOR SHALL VERIFY ACTUAL DEPTH AND LOCATION OF ALL EXISTING UTILITIES PRIOR TO CONSTRUCTION...CALL 811 TO CONTACT "UNDERGROUND SERVICE ALERT" (U.S.A.) PRIOR TO TRENCHING, GRADING, EXCAVATION, DRILLING, PIPE PUSHING, PLANTING TREES, DIGGING POST HOLES FOR FENCES, ETC. U.S.A. WILL SUPPLY INFORMATION OR LOCATE AND MARK ANY UNDERGROUND FACILITIES.

- NOTE:**
- CONTRACTOR SHALL POT HOLE & VERIFY UTILITY POINTS OF CONNECTION PRIOR TO BEGINNING WORK.
 - REMOVE & REPLACE STRIPING & LEGEND IN-KIND AS NEEDED.
 - SEWER SERVICES WITH CLEAN-OUT PER CITY STANDARD S-7 SHALL BE 4" IN SIZE UNLESS CALLED OUT OTHERWISE.
 - SEWER PIPE CONNECTION TO MANHOLE: CONNECT PIPE TO MANHOLE WITH RUBBER GASKET & NON-SHRINK GROUT IN ANNULAR SPACE.
 - CURB & GUTTER TO BE PROTECTED IN-PLACE.
 - SEE SURVEY NOTES, NOTE 5 FOR MONUMENT PRESERVATION. (TYPICAL)
 - WHERE SANITARY SEWER SERVICE LATERALS CROSSING WITHIN 12" OF WATER MAIN, A 20' MINIMUM SECTION OF PVC "C900-07; PRESSURE CLASS 305, OR 14" SECTION SHALL BE CENTERED ON THE WATER MAIN. FIELD VERIFY LOCATION AND ELEVATIONS OF EACH LATERAL AT PROPOSED CLEANOUT POINT OF CONNECTION PRIOR TO INSTALLATION OF THE MAIN.
- PAVING LEGEND:**
- | | |
|--|-------------------------------------|
| | TRENCH PATCH & GRINDING |
| | SEE TRENCH PATCH DETAIL T-1 AND T-2 |

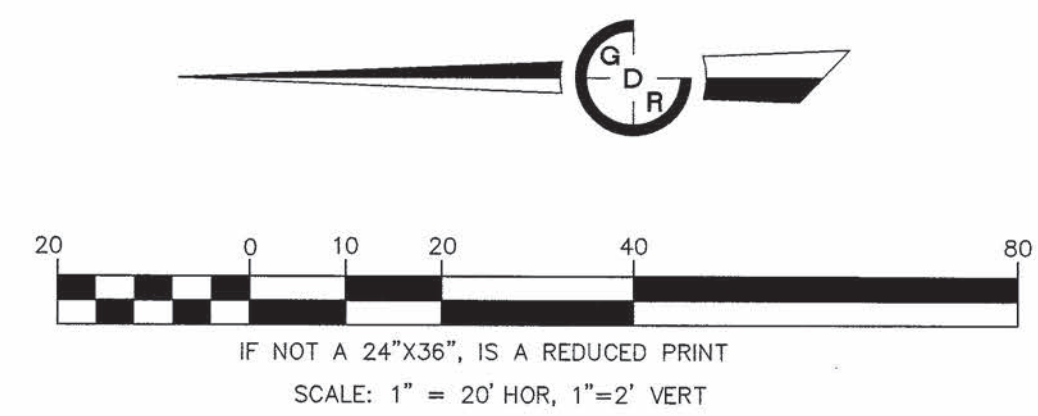

Jason K. Chapman
REGISTERED PROFESSIONAL ENGINEER
JASON K. CHAPMAN
No. 66134
CIVIL
STATE OF CALIFORNIA
11/12/2025
DATE SIGNED:

CAUTION: UNAUTHORIZED CHANGES AND USES THE ENGINEER PREPARING THESE PLANS WILL NOT BE RESPONSIBLE FOR OR LIABLE FOR UNAUTHORIZED CHANGES TO OR USES OF THESE PLANS. ALL CHANGES TO THE PLANS MUST BE IN WRITING AND MUST BE APPROVED BY THE PREPARER OF THESE PLANS AND THE CITY ENGINEER.		GDR ENGINEERING, INC. ENGINEERING/SURVEYING/PLANNING 3525 MITCHELL ROAD, SUITE G CERES, CA 95307 TELEPHONE: (209) 538-3360 FAX: (209) 538-7370 E-MAIL: GDRENGINEERING@GDRENGR.COM	
ADDENDUM 1 - ADDED SS LATERAL TRENCH PATCH 11/13/25 JA		CITY OF TURLOCK - CP 25-051 EL PASEO SANITARY SEWER MAIN REPLACEMENT EL PASEO STREET PLAN AND PROFILE	
SCALE: AS NOTED		DATE: 11/12/2025	
DWG NO. 250500SGN-CP 25-051.dwg LAYOUT 4-PP		SHEET: 4 OF 6	
DRAWN: JA		FILE NO.: 25050	
DESCRIPTION	DATE	BY	CHECKED:

